CORPS OF ENGINEERS

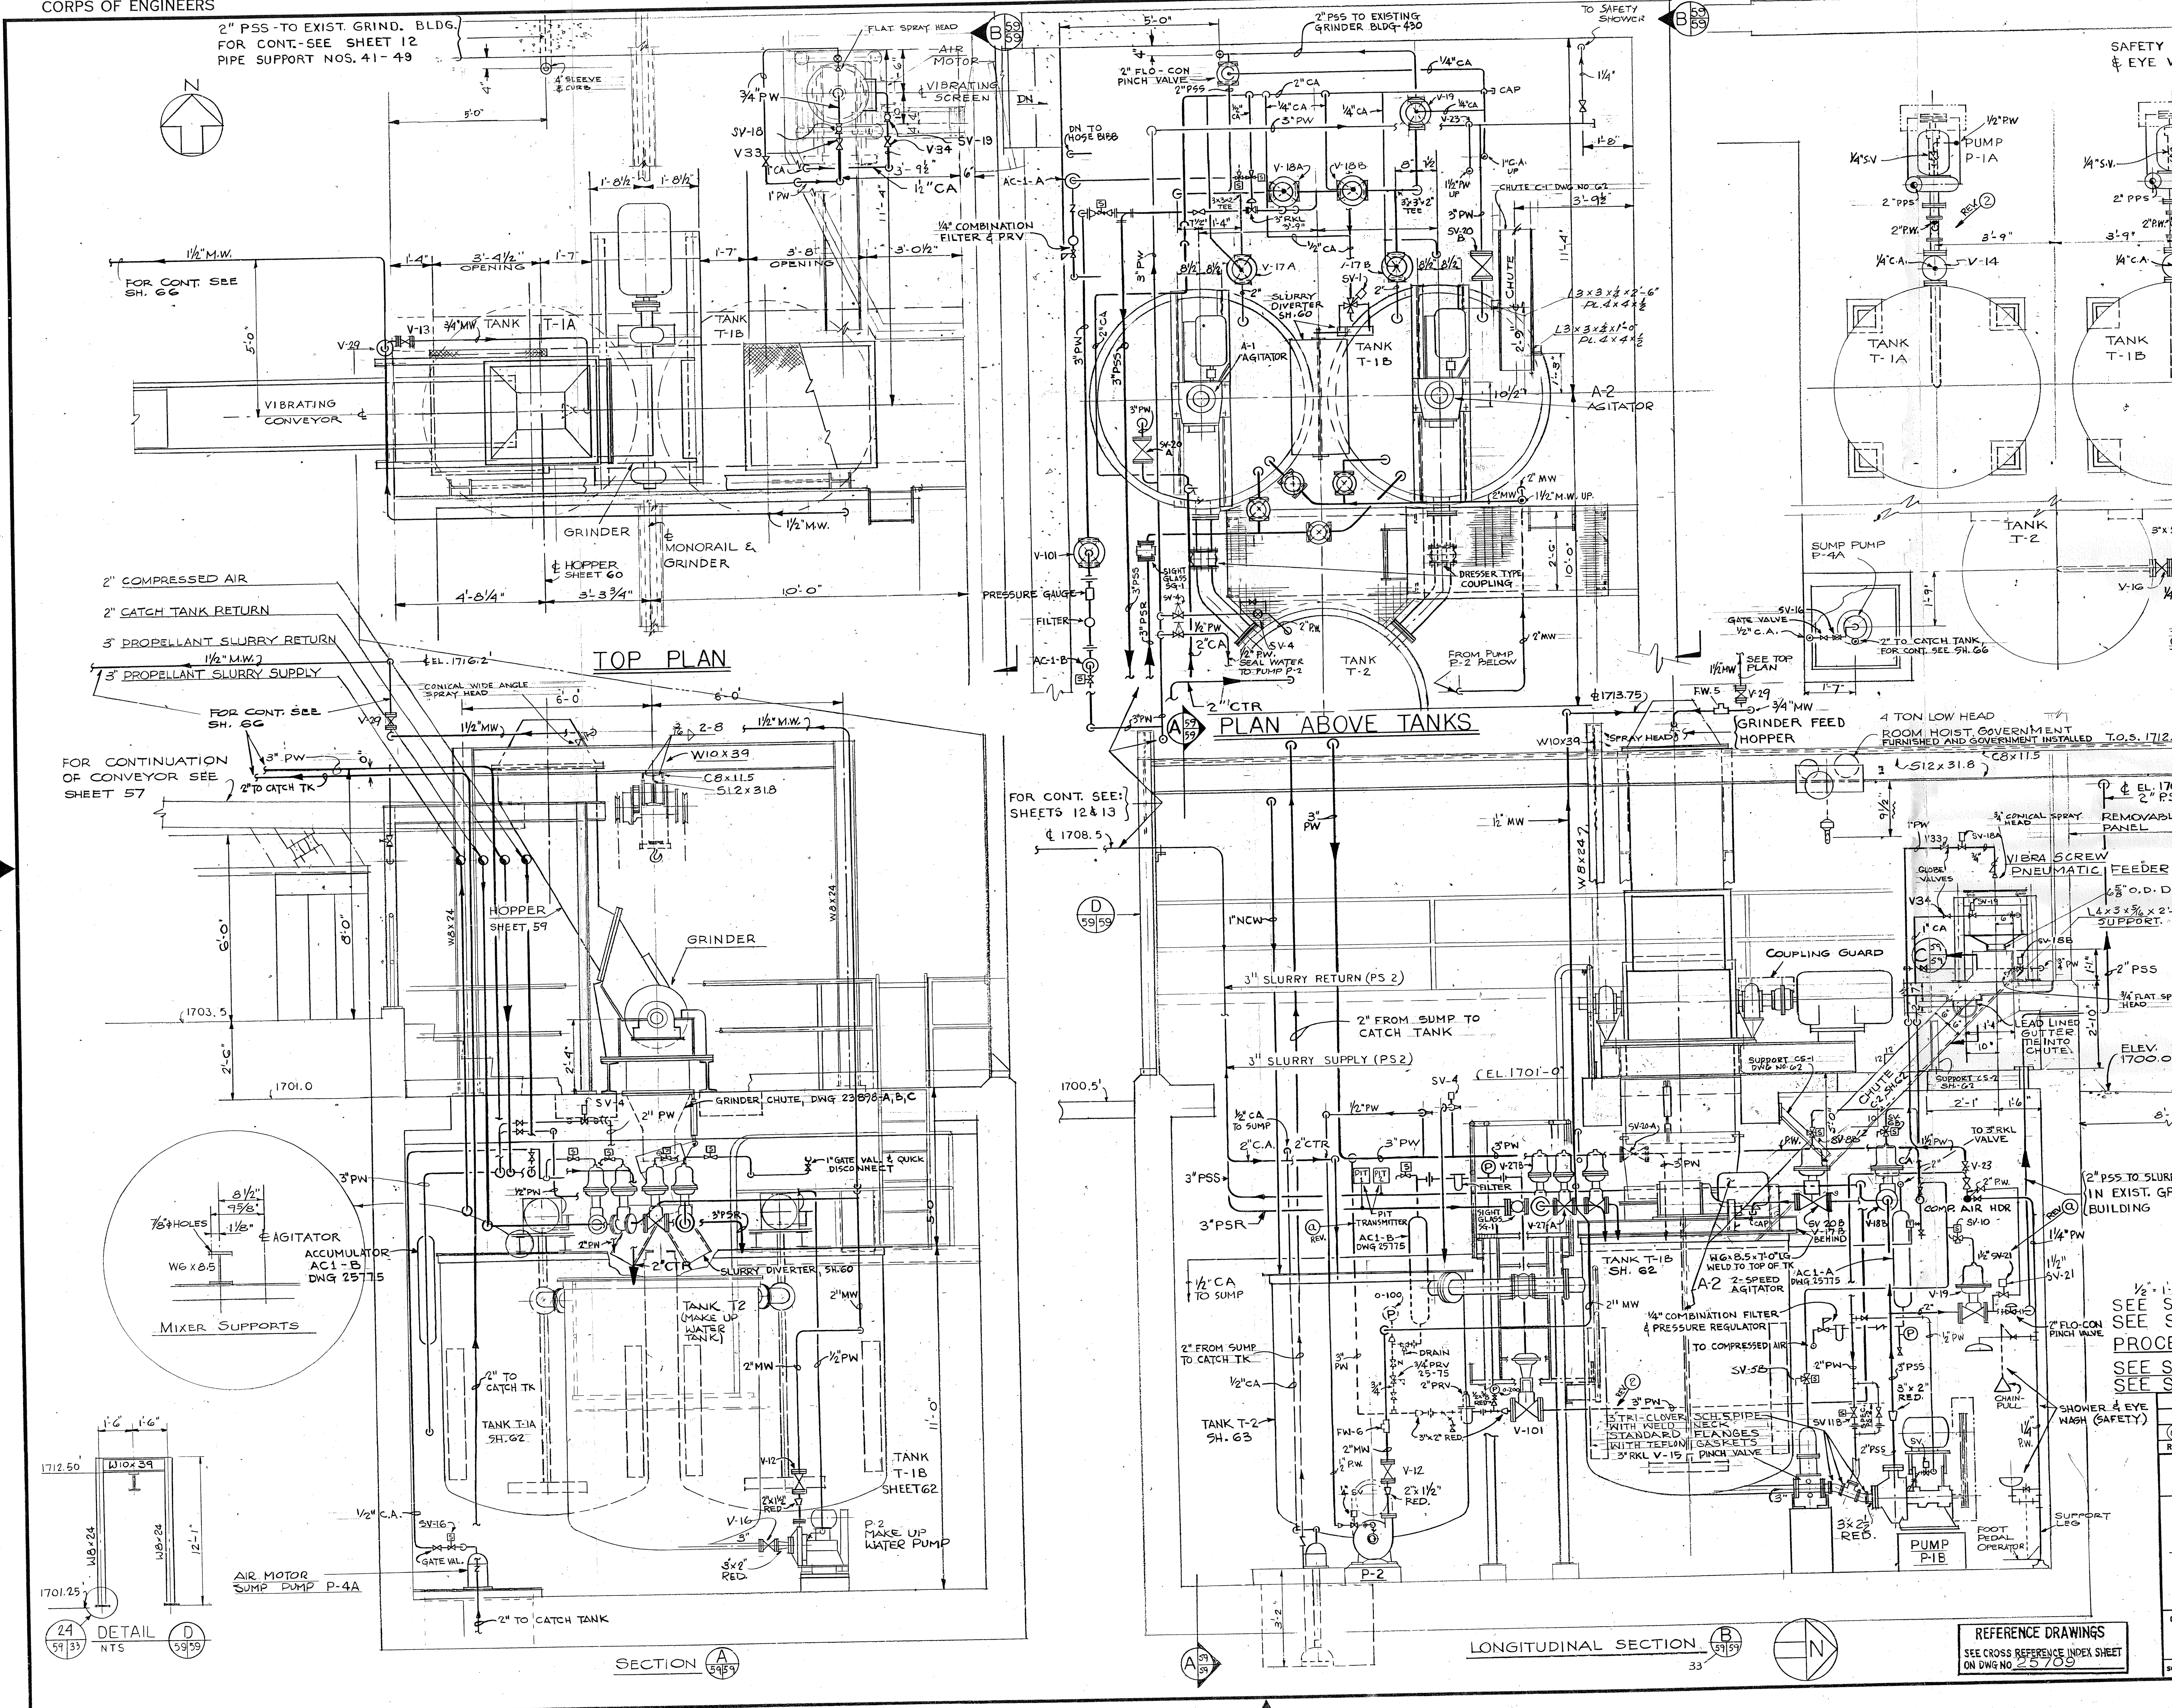

1/2" = 1'-0"

SEE SHEET 66 FOR LEGEND
SEE SHEET 51 FOR GRINDER BLDG. PROCESS FLOW DIAGRAM
SEE SHEETS 12, 13 & 66 FOR PIPING
SEE SHEET 64 FOR AIR PIPING

REVISIONS

	DESCRIPTION	DRAFTING DRAWN	DATE	CHECKED	APPROVAL ENG.	OPER.	SAFETY
②	CHANGED TRI-CLAMP CONNECTORS TO WELD NECK STANDARD FLANGES WITH TEFLON GASKETS	HENDRICKS	7-13-83	SMP	7/28/83	10/5/83	
①	REVISED PIPING & EQUIPMENT, RELOCATED "FAIL SAFE" SYSTEM FROM INCINERATORS 440 & 441 TO SLURRY PIT IN GRINDER BLDG 442, AS BUILT.	C. McCoy	4-16-82	GCS	5-25-83	5/25/83	

REV	DATE	DESCRIPTION	BY
@	9/13/76	ADDED SV 21 & PIT TRANSMITTERS	JRR

DEPARTMENT OF THE ARMY
BALTIMORE DISTRICT, CORPS OF ENGINEERS
BALTIMORE, MARYLAND

RADFORD ARMY AMMUNITION PLANT
LINE ITEM 6A FY72MCA
WASTE PROPELLANT INCINERATOR

GRINDER AND SLURRY TANK ARRANGEMENT

OFFICE of J. FRUCHTBAUM ASSOCIATES
1965 SHERIDAN DRIVE
BUFFALO, NEW YORK 14223
ARCHITECTS - ENGINEERS

DRAWING NUMBER: Figure III.1.A-2
PLATE

SCALE: 1/2" = 1'-0" | DATE: 15 NOV. 1974 | SHEET 59

REFERENCE DRAWINGS
SEE CROSS REFERENCE INDEX SHEET ON DWG NO 25709

NORFOLK DISTRICT FILE NUMBER RAD 48-156

0	4	4	2	0	0	2	5	7	6	4	F	3	5	6	0	2

ACCOUNT NO. | SERIAL NO. | CLASS CODE | REV.

AS BUILT