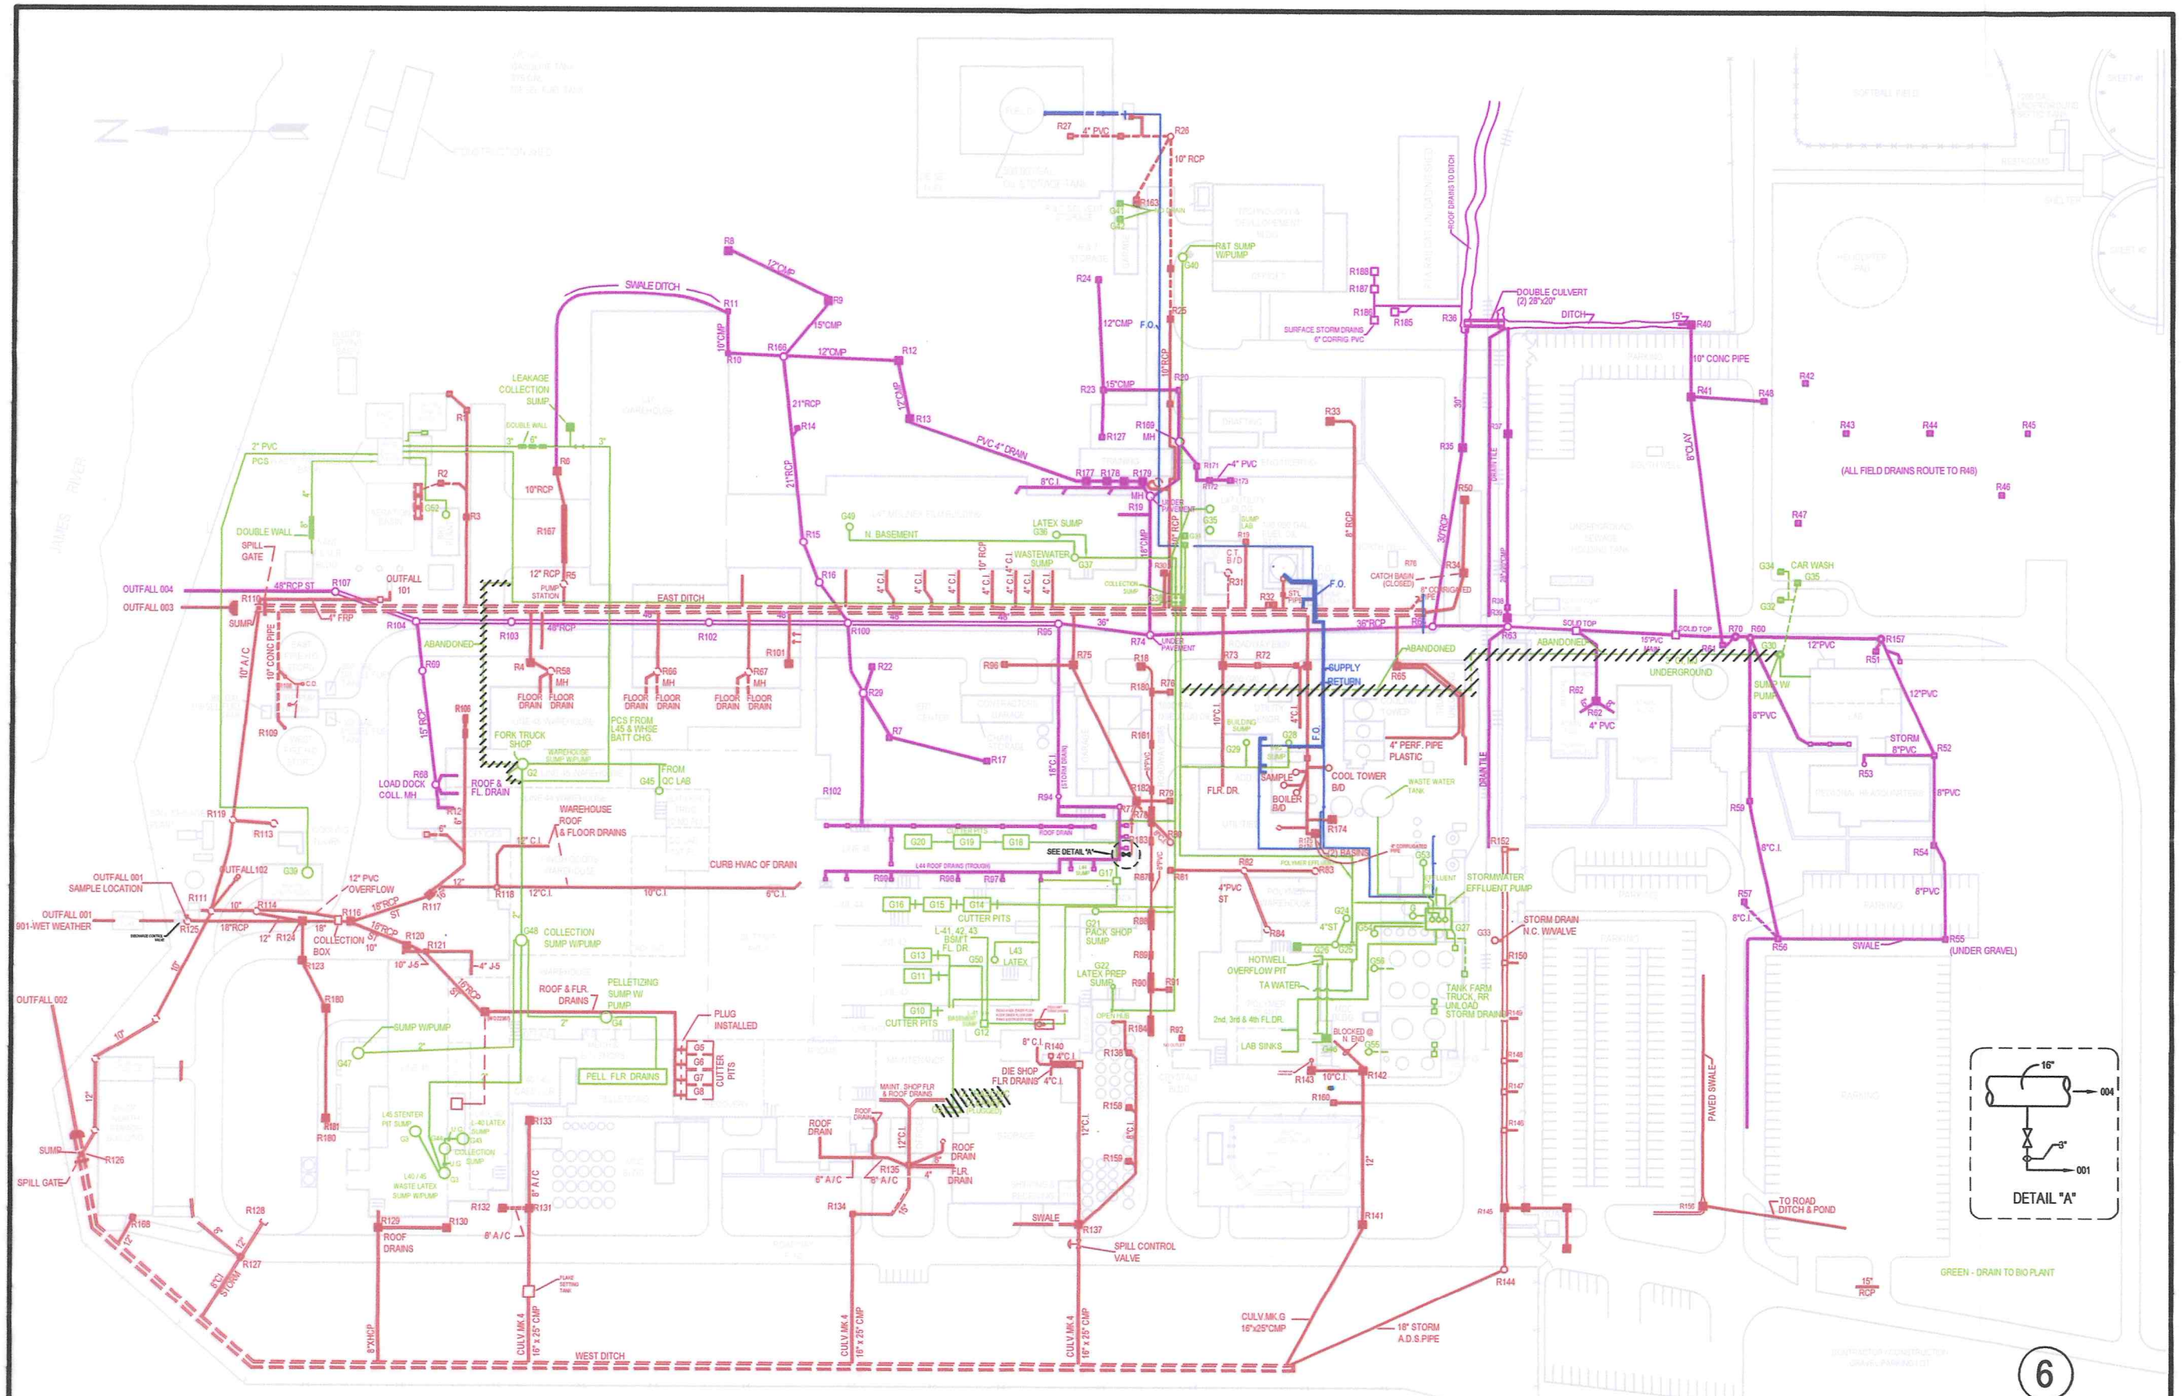

FOR REFERENCE ONLY - THIS DRAWING IS LAYER SIX OF 8594002 .dwg - ALL REVISIONS MUST BE MADE ON 8594002.dwg ALSO.

SEE LAYER SUMPTEXT FOR LIST AND LOCATIONS OF SUMPS
RED - DRAIN TO RIVER VIA OUTFALLS 001,002,003
BLUE - FUEL OIL LINES
MAGENTA - DRAIN TO RIVER VIA OUTFALL 004

CAD REFERENCE FILE
8594002-6.dwg

REV	DATE	BY	APPVD	DESCRIPTION	REFERENCE DRAWINGS	REFERENCE DRAWINGS
22	9/12/03	LTQ		ISSUED AS BUILT	9789.002	
23	7/30/14	WRK	MEH	UPDATED FROM REV 22 PER W. LANNING & J. FORSTNER		

PROPRIETARY STATEMENT

This drawing has been furnished by E I du Pont de Nemours and Company. The information and know-how thereon may not be used nor the drawing reproduced without the written permission of Dupont. All reproductions in whole or in part, vendor's shop drawings, shall bear or refer to this stamp.

STANDARDS AND SPECIFICATIONS

DWG. SCALE	PLOT SCALE
AS NOTED	E-SIZE 1:1

APPROVALS		
	DATE	BY
DRAWN BY		
PLANT	HOPEWELL	
CHARGE		
PROJECT	HW40042	

DIMENSIONS
ALL DIMENSIONS ARE FINISHED SIZE, NO MACHINING ALLOWANCES MADE EXCEPT WHERE SHOWN.
DECIMAL DIMENSIONS ± 0.03
FRACTIONAL DIMENSIONS ± 1/64
ANGULAR DIMENSIONS ± 1°
UNLESS OTHERWISE STATED

WELDING
OR INDICATES WELD

DuPontTeijinFilms
HOPEWELL SITE
P.O.BOX 411
BERMUDA HUNDRED
HOPEWELL, VA 23860

TITLE
MASTER SITE PLAN
PROCESS SEWER AND STORM DRAINS
SHEET 2-6A

DRAWING NUMBER: 8594.002-6A | REV. 23 | CLASS L